



E692198
N721752

PAL

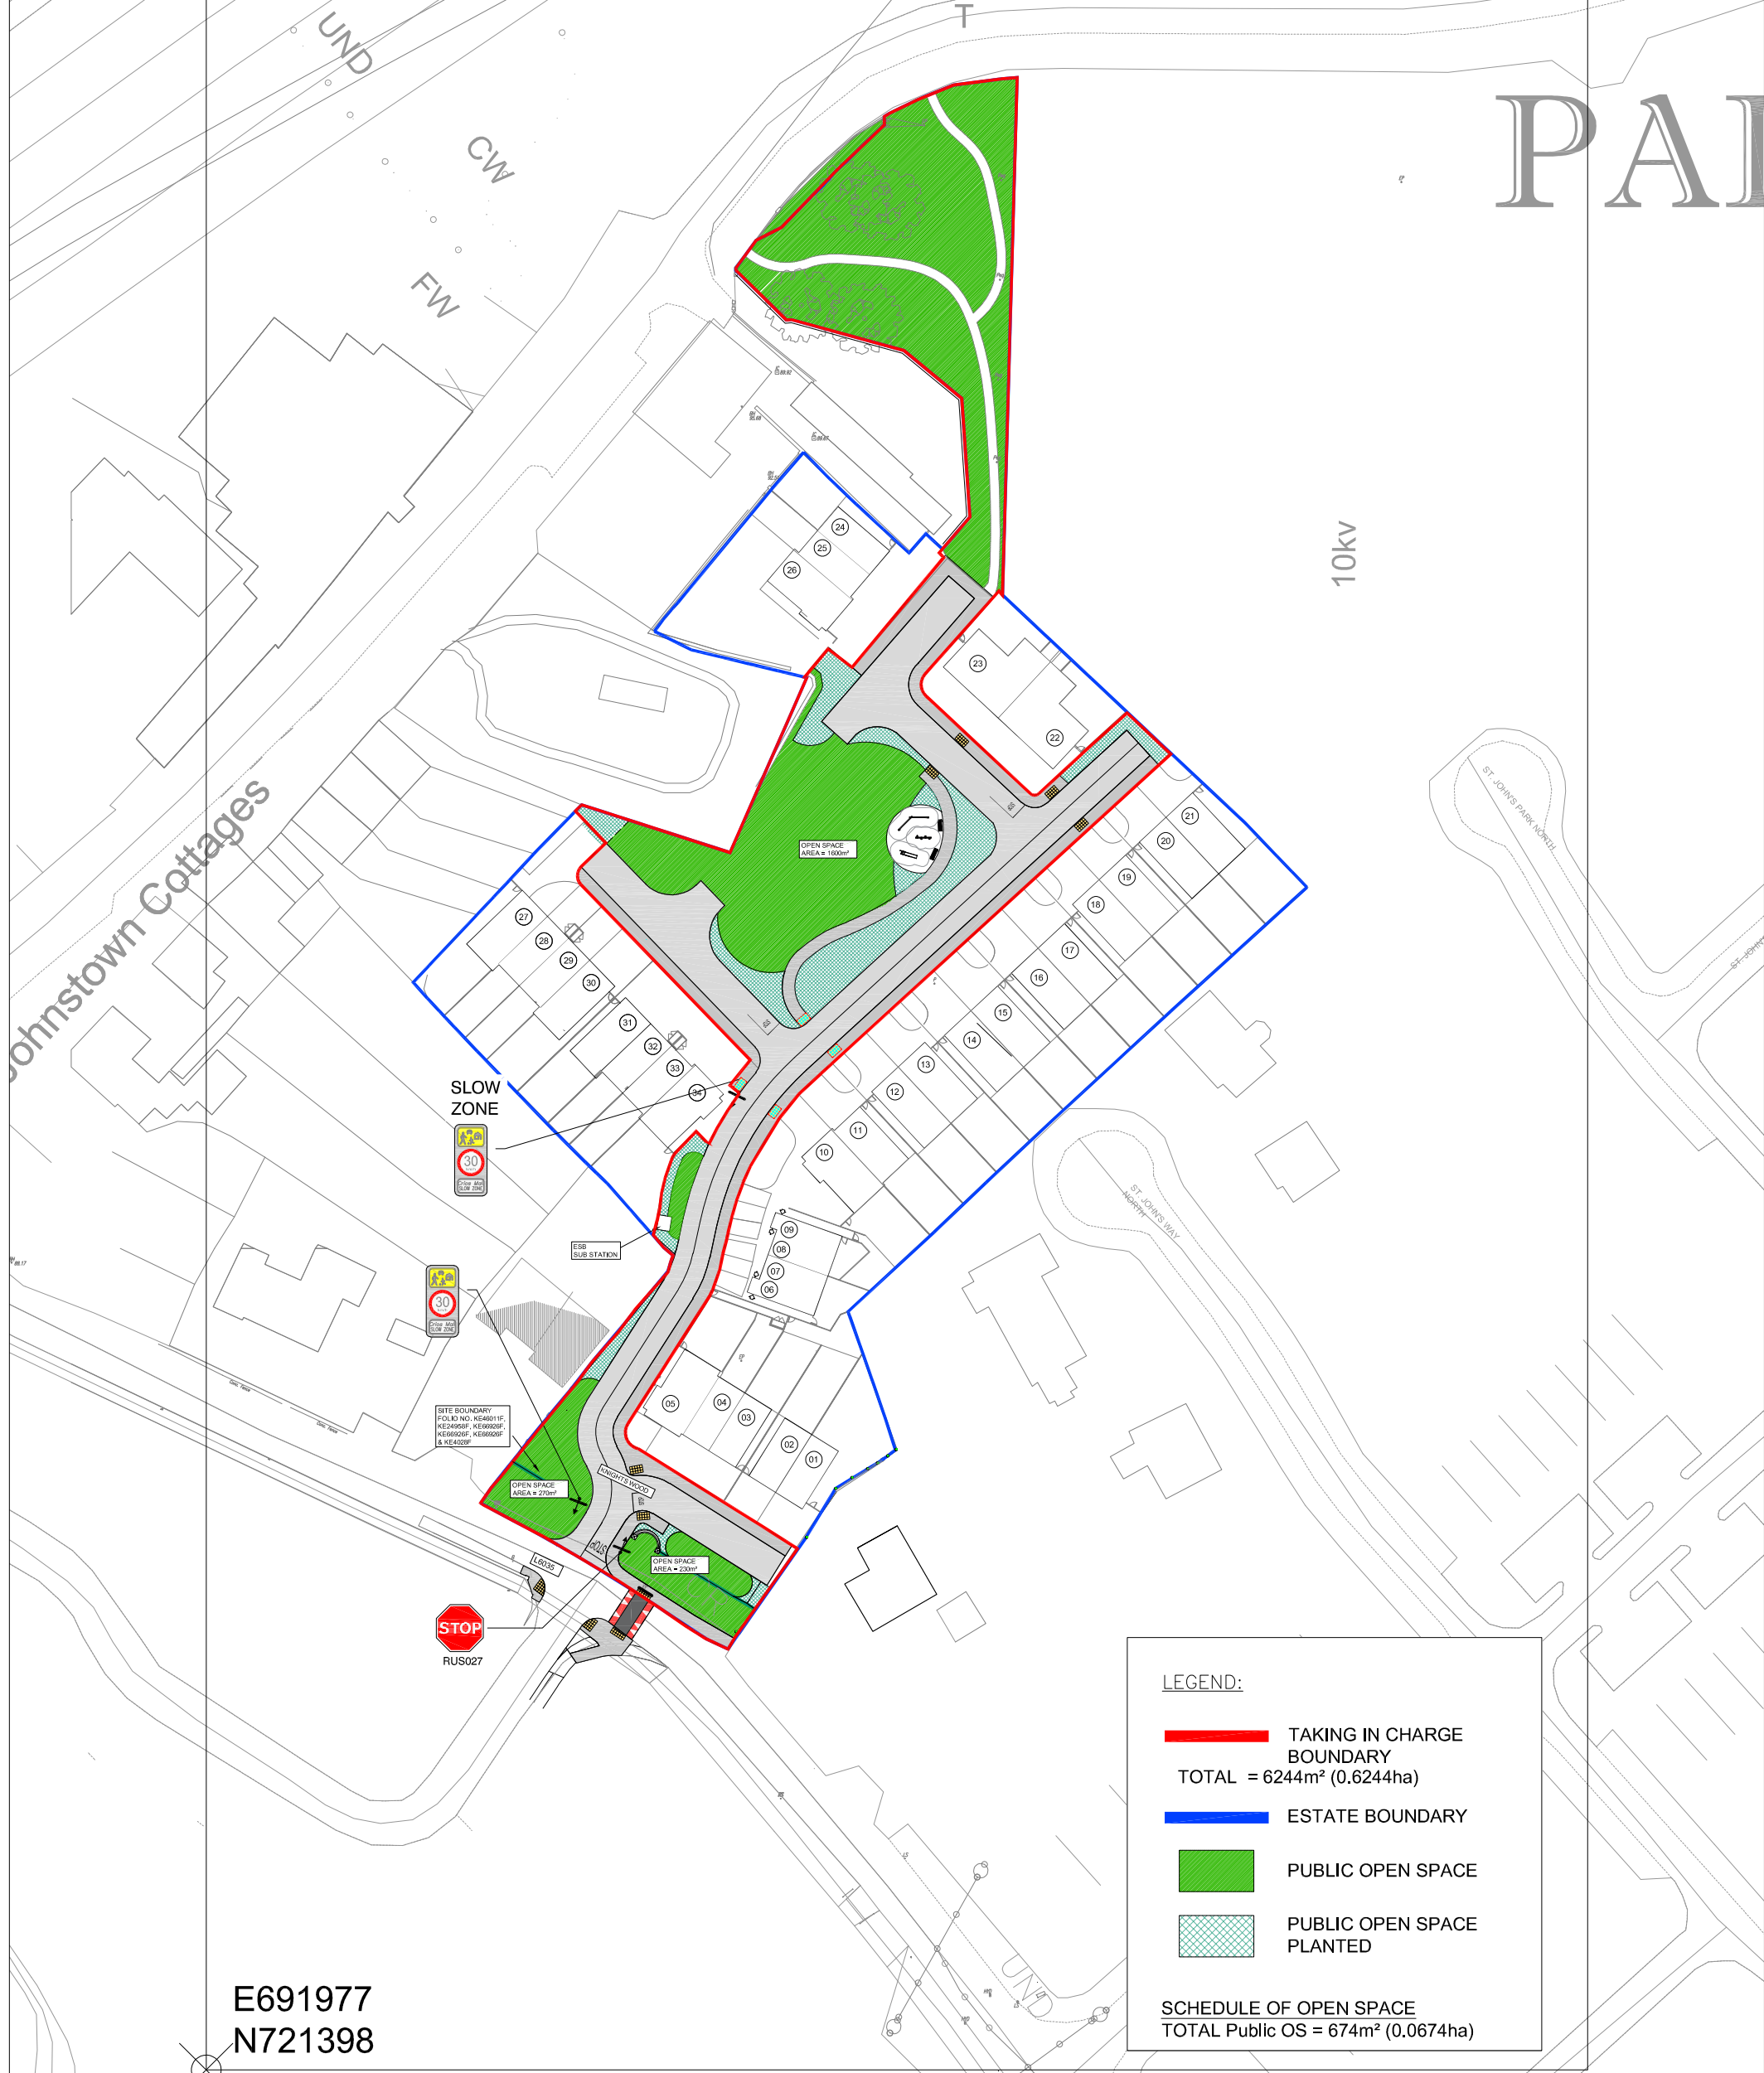

E691977
N721398

REV	DESCRIPTION	DATE	BY	CHK	PROJECT	PROPOSED DEVELOPMENT AT KNIGHTSWOOD JOHNSTOWN CO. KILDARE	DWG NO	TIC-001
					DRAWING TITLE	PUBLIC DISPLAY MAP FOR TIC	SCALE	1:500 @ A3
					CLIENT	WESTIN HOMES LTD.	DATE	23-09-22
					STATUS	AS BUILT	BY	ROH
							CHK	EF
							REV	---
							REF	21-D1

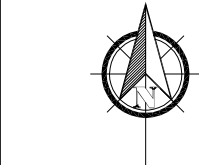

(+353) 45 486 229
fureyconsulting.ie
Olde World Cottage,
Rathasker Road,
Naas, Co. Kildare

FUREY
CONSULTING ENGINEERS